



**ATTACHMENT A3**

**~~DRAWING NUMBER 51-W-214-W~~**  
**~~UNDERGROUND FACILITIES~~ TYPICAL DISPOSAL PANEL**

(This page intentionally blank)

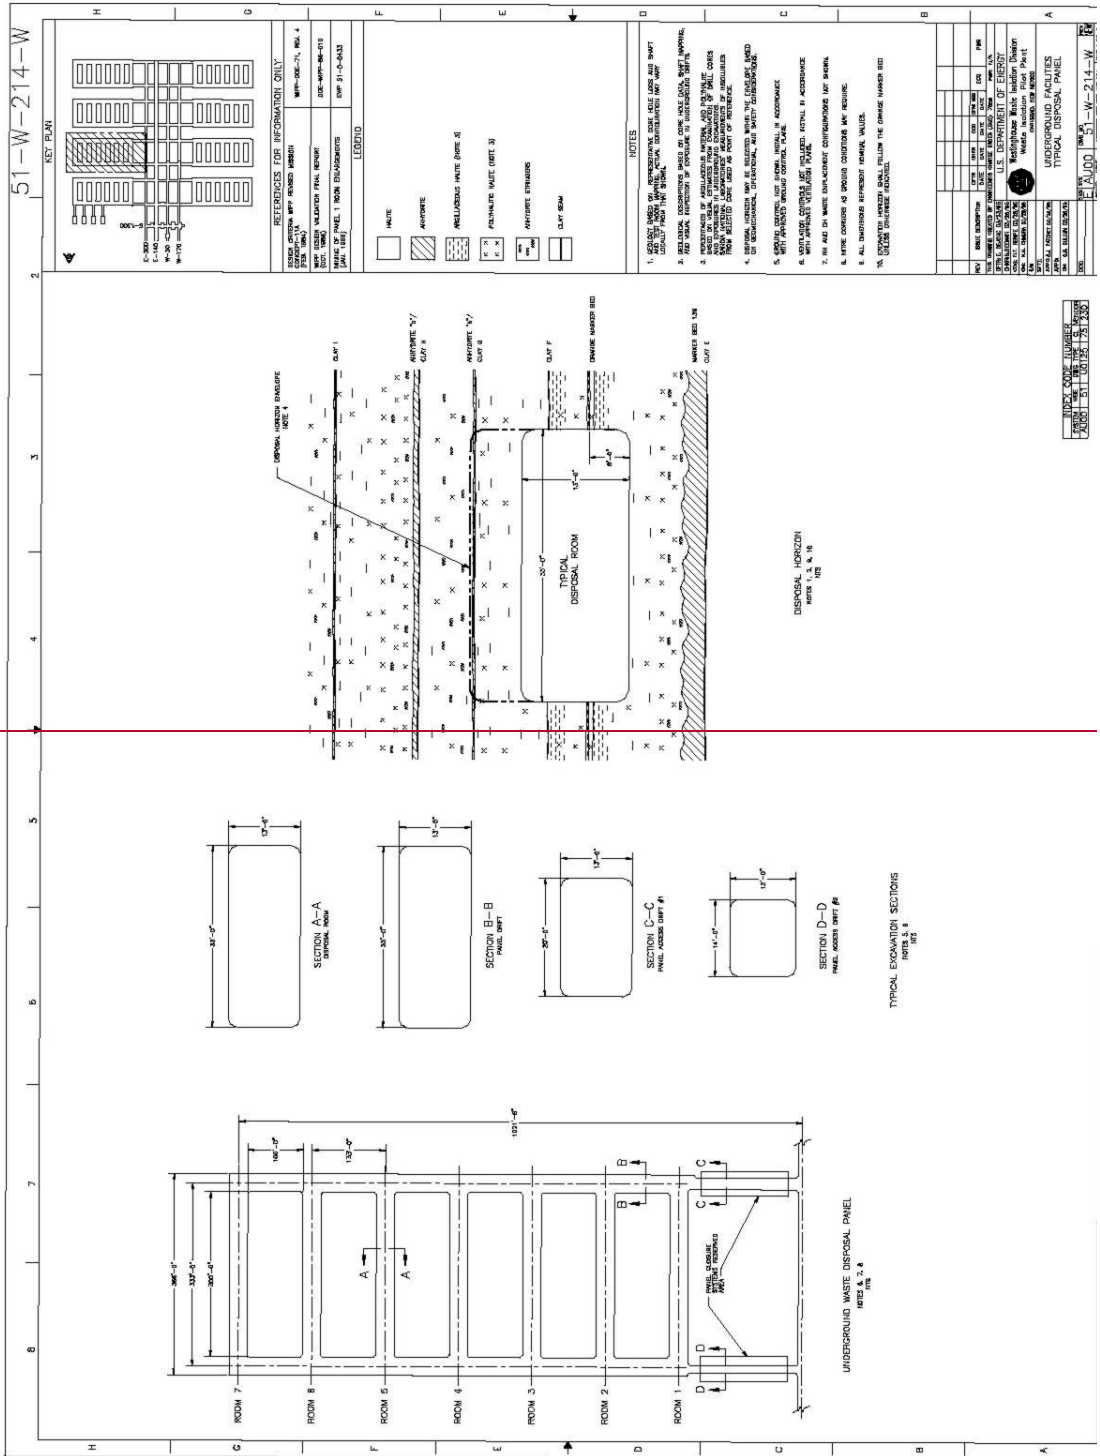

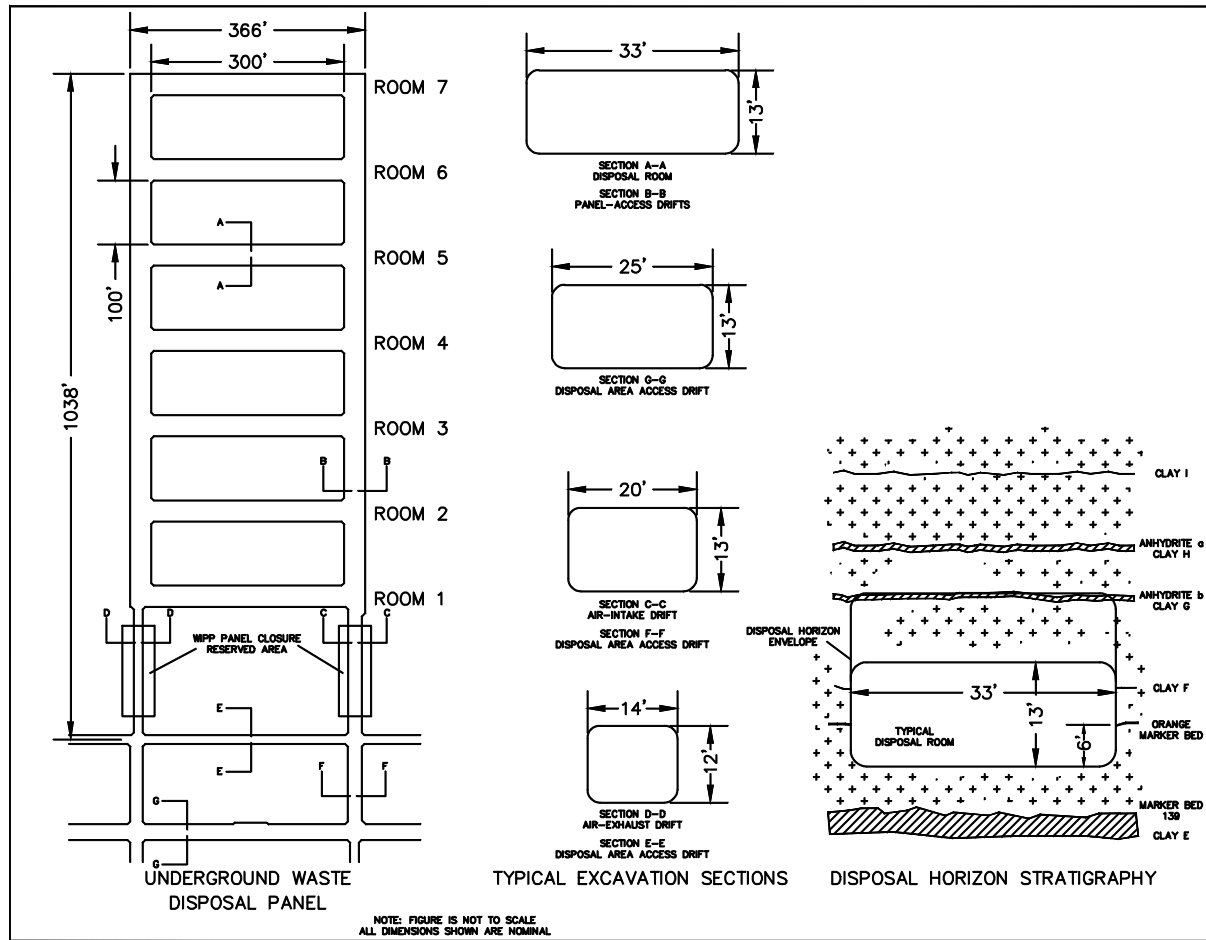

**Drawing 51-W-214-W Underground Facilities Typical Disposal Panel**

1  
 2

1

(This page intentionally blank)